


58WS-7213-B

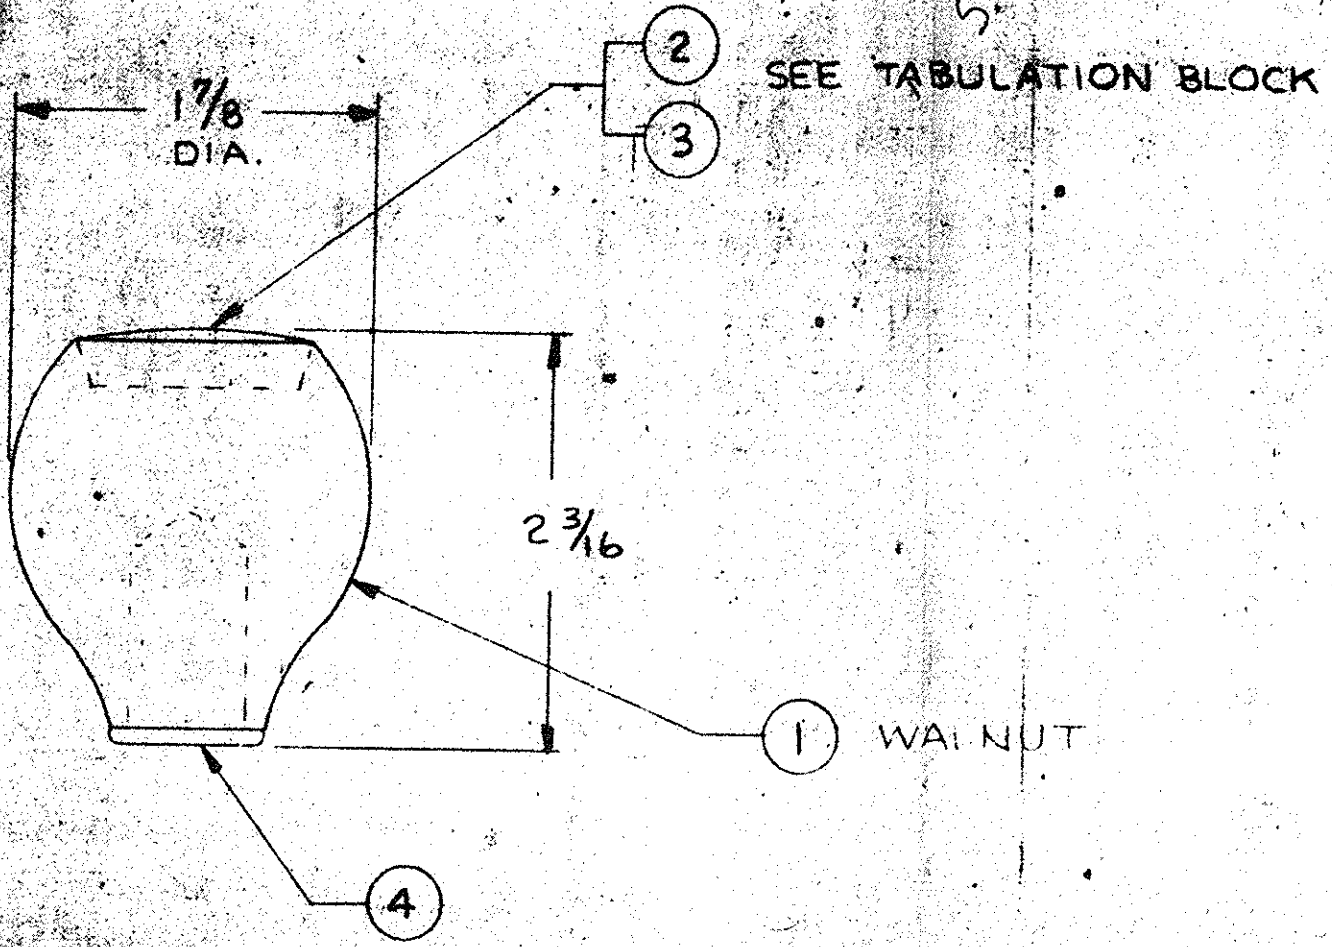

REVISIONS			
REV	DESCRIPTION	DATE	REVISED BY

TABULATION BLOCK		
ITEM NO.	PART NO.	FOR USE ON-
3	<del>1000H-1</del> SBMS-7213-B	COBRA
2	<del>1000H-2</del> SBWS-7213-B	COUGAR

EC NO.	CHG LET.	REVISIONS	DATE	BY	CHK.
		REL FOR 1968 COUGAR			
		REL FOR PRODUCTION	68		

NOTES:

4	1		1/2-20 INSERT	
3	1	<del>1000H-1</del> SBMS-7213-B	COBRA	
2	1	<del>1000H-2</del> SBWS-7213-B	COUGAR	
1	1		KNOB	
ITEM NO.	REQ'D	PART NO.	DESCRIPTION	CUST P/N
SCALE: FULL		APPROVED BY:		DRAWN BY: BALED
DATE: 1-16-68		CUST: SHELBY AMERICAN		REVISED
		CUST P/N		
ACSCO PRODUCTS INC. BURBANK, CALIFORNIA				
SHIFT KNOB (4 SPEED)			DRAWING NUMBER	1000H-1-2

SBWS-7213-B  
SBMS-7213-B