


SBWS-7213-A

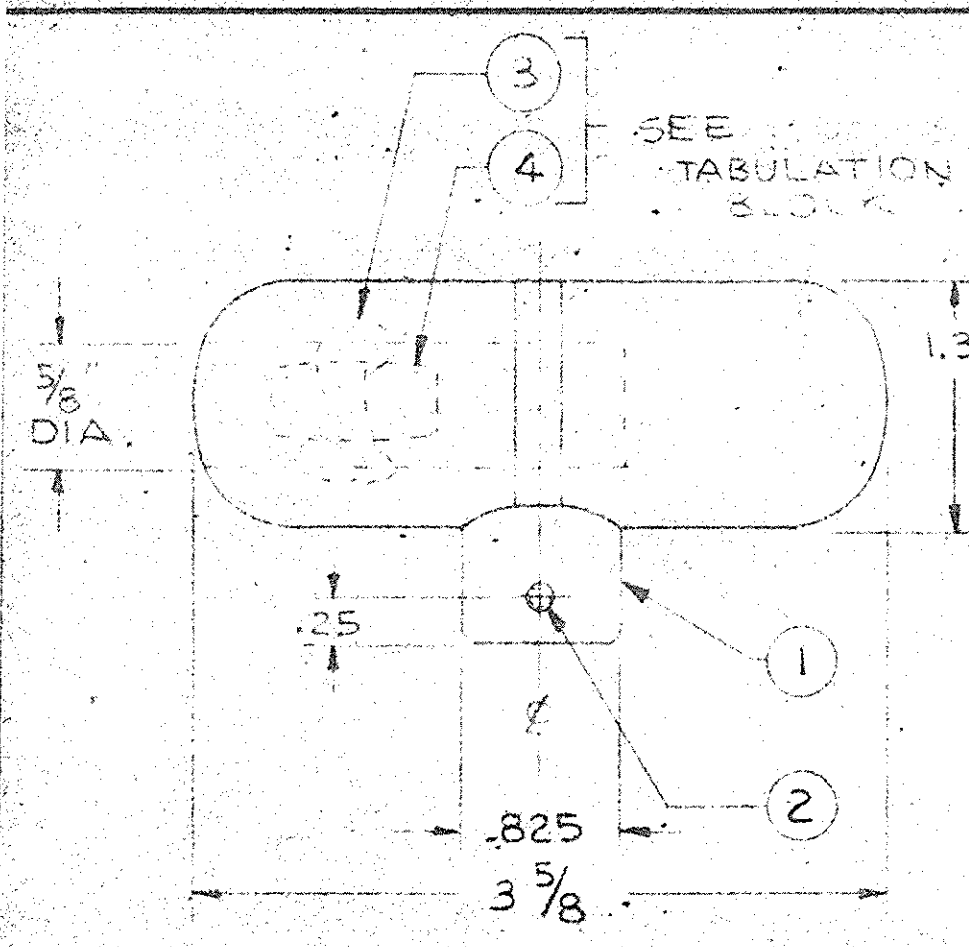

REVISIONS			
REV	DESCRIPTION	DATE	REV BY

TABULATION BLOCK		
ITEM NO	PART NO	FOR USE ON
3	<del>100012-1</del> SBMS-7213-A	COBRA
4	<del>100012-2</del> SBWS-7213-A	COUGAR

E.C. NO.	CHG. LET.	REVISIONS	DATE	BY	CK.
-		REL FOR 1968 COUGAR	1-30-68	R	RZ
-		REL. FOR PRODUCTION CB	1-30-68	R	RZ

4	1	<del>100012-2</del> SBWS-7213-A	COUGAR
3	1	<del>100012-1</del> SBMS-7213-A	COBRA
2	1		SET SCREW 10-32
1	1	100013	T-HANDLE

ITEM NO.	REQD	PART NO.	DESCRIPTION	CUST P/N

SCALE: FULL  
 DATE: 1-16-68  
 APPROVED BY: J. BALCOM  
 CUSTOMER: SHELBY AMERICAN  
 DRAWN BY: J. BALCOM  
 REVISED: -  
 ACSCO PRODUCTS INC.  
 BURBANK, CALIFORNIA  
~~T-SHIFT~~ SHIFT KNOB (AUTOMATIC)  
 DRAWING NUMBER: ~~100012-1-2~~

1. PUSH BUTTON TO BE SUPPLIED BY CUSTOMER.  
 NOTES:

SBWS-7213-A  
 SBMS-7213-A