4-29-68	—	REL. FOR PRODUCTION			
DATE	LET	REVISIONS	REL. NO.	DR.	CK.

58WS-501L97-A

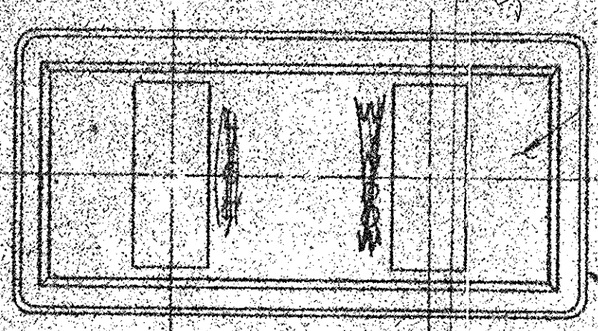

7X0706B-3
~~68-0789-2~~ INSERT

7X0706B-2
~~68-0789-2~~ Housing

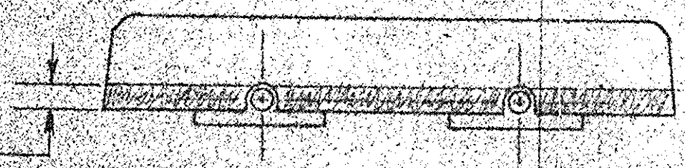

MILL .180
CONSTANT

REF.
68-0789-2

A	Revised per Engr. Order 68-0789				
LET	REVISIONS	W. ST. MFG.	DATE	CK.	

"T" PRINT RELEASE
TO TOOLING
RELEASE 3-22-68
REVISED

TOLERANCES UNLESS OTHERWISE SPECIFIED
LINEAR PLUS OR MINUS .010 ANGULAR PLUS OR MINUS 1° DECIMAL

MATERIAL CERTIFIED YES ☐	SCALE	DATE	DRAWN	CHECKED	ENGINEER	STATUS
	FULL	1-31-68	TK		WFS	P
GRAIN DIRECTION	1 2 3 4 5 6 7 8 9 10 11 12 13 14 15 16 17 18 19 20 21 22 23 24 25 26 27 28 29 30	FIRST USED 68-0985-B				
TOOLER		CAT. NO. 7X0706B-3				
HARDNESS		NAME HOUSING ASSEMBLY				
FINISH						

SK — FEDERAL MOGUL CORPORATION, ELECTRO-MECHANICAL DIV., DETROIT, MICHIGAN

58WS-501L97-A
~~7X0706B-1~~

58WS-501L97-A

REV. 1-8-68 PER CRS-1452 FOR REV. 1 ON DRAWING